

Date: Thursday, 02/11/2006 3:28:14 PM
 User: Linda Lacelle

Process Sheet

Customer : CC-DAR01 Dart Aerospace Ltd.
 Job Number : 29261
 Estimate Number : 10804
 P.O. Number : *N/A*
 This Issue : 02/11/2006 S.O. No. : *N/A*
 Prsht Rev. : NC
 First Issue : *N/A* Type : LANDING GEAR
 Previous Run : 29256
 Written By : *[Signature]*
 Checked & Approved By : *[Signature]*
 Comment :

Drawing Name : D206667101
 Part Number : D206667101
 Drawing Number : CHG 002
 Project Number : *N/A*
 Drawing Revision : *N/A*
 Material : *N/A*
 Due Date : 10/11/2006 Qty: 1 Um: Each

Additional Product

Job Number:



DART		TEL: 1-613-632-3336 FAX: 1-613-632-4443	
TRANSPORT CANADA APPROVAL # 09-89			
P/N	D206-667-101	Q/C	CHG001
DESC	Crosstube Fwd High	SIC	SH01-5
LOT	B17013	SIC	SR01304NY
MODEL	206A/B	SIC	
MADE IN CANADA			

Seq. #: Machine Or Operation: Description :

1.0 LANDING GEAR 1 LANDING GEAR RESOURCE 1



Comment: LANDING GEAR RESOURCE 1

BUFF CUFFS, DRILL OEM HOLES PER CHG 002 *RT 06-11-09*

2.0 D206667101 Crosstube Installation

** N260 D25 9346 Rev C*



Comment: Qty.: 1.0000 Each(s)/Unit Total : 1.0000 Each(s)

Crosstube Installation
B 17013 RT 06-11-09

3.0 QC5 INSPECT WORK TO CURRENT STEP



Comment: INSPECT WORK TO CURRENT STEP

06-11-20 (1)

4.0 SPRAY PAINTING SPRAY PAINTING



Comment: SPRAY PAINTING

MASK AND
 RE-PRIME & REPAINT CUFFS *MM 06 11 22 (1)*

5.0 QC14 Inspect Spray Paint



Comment: Inspect Spray Paint

06/11/23 (1)

Dart Aerospace Ltd

W/O:		WORK ORDER CHANGES					
DATE	STEP	PROCEDURE CHANGE	By	Date	Qty	Approval Chief Eng / Prod Mgr	Approval QC Inspector

Part No: _____ PAR #: _____ Fault Category: _____ NCR: Yes No DQA: _____ Date: _____

QA: N/C Closed: _____ Date: _____

NCR:		WORK ORDER NON-CONFORMANCE (NCR)						
DATE	STEP	Description of NC Section A	Corrective Action Section B			Verification Section C	Approval Chief Eng	Approval QC Inspector
			Initial Chief Eng	Action Description Chief Eng	Sign & Date			

NOTE: Date & initial all entries

Date: Thursday, 02/11/2006 3:28:14 PM
User: Linda Lacelle

Process Sheet

Customer: CC-DAR01 Dart Aerospace Ltd.

Drawing Name: D206667101

Job Number: 29261

Part Number: D206667101

Job Number:



Seq. #:	Machine Or Operation:	Description :
---------	-----------------------	---------------

6.0	D2873043	Nut Plate Assembly
-----	----------	--------------------



Comment: Qty.: 2.0000 Each(s)/Unit Total : 2.0000 Each(s)

Pick:

Qty Part number Description Batch

2 D2873-043

Nut Plate

28075

8T 06-11-09

7.0	D2873045	Nut Plate Assembly
-----	----------	--------------------



Comment: Qty.: 2.0000 Each(s)/Unit Total : 2.0000 Each(s)

Pick:

Qty Part number Description Batch

2 D2873-045

Nut Plate

28076

8T 06-11-09

8.0	MS20601AD4W8	
-----	--------------	--



Comment: Qty.: 14.0000 Each(s)/Unit Total : 14.0000 Each(s)

Pick:

Qty Part number Description Batch

14 MS20601AD4W8 Rivet

100771

8T 06-11-09

9.0	QC5	INSPECT WORK TO CURRENT STEP
-----	-----	------------------------------



Comment: INSPECT WORK TO CURRENT STEP

206-11-20

10.0	PACKAGING 1	PACKAGING RESOURCE #1
------	-------------	-----------------------



Comment: PACKAGING RESOURCE #1
REPACKAGE PER PPP

11.0	AN57A	Bolt
------	-------	------



Comment: Qty.: 10.0000 Each(s)/Unit Total : 10.0000 Each(s)


Bolt

M102140

QB 06/11/27

(P70)

Dart Aerospace Ltd

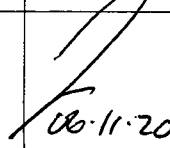W/O:		WORK ORDER CHANGES					
DATE	STEP	PROCEDURE CHANGE	By	Date	Qty	Approval Chief Eng / Prod Mgr	Approval QC Inspector
06-11-20	801	Install rivets: nut plates As per DWG:	BT	06-11-21	1		 06-11-20

Part No: _____ PAR #: _____ Fault Category: _____ NCR: Yes ☒ No ☐ DQA: DP Date: 06/11/28
 QA: N/C Closed: _____ Date: _____

NCR:		WORK ORDER NON-CONFORMANCE (NCR)						
DATE	STEP	Description of NC Section A	Corrective Action Section B			Verification Section C	Approval Chief Eng	Approval QC Inspector
			Initial Chief Eng	Action Description Chief Eng	Sign & Date			

NOTE: Date & initial all entries

Date: Thursday, 02/11/2006 3:28:14 PM
User: Linda Lacelle

Process Sheet

Customer: CC-DAR01 Dart Aerospace Ltd.

Drawing Name: D206667101

Job Number: 29261

Part Number: D206667101

Job Number:



Seq. #:

Machine Or Operation:

Description:

12.0

AN530A

BOLT



Comment: Qty.: 4.0000 Each(s)/Unit Total: 4.0000 Each(s)
BOLT M100473 ✓

~~N/A~~

13.0

AN960JD516

Washer



Comment: Qty.: 10.0000 Each(s)/Unit Total: 10.0000 Each(s)
Washer M100564 ✓

~~N/A~~

2306/11/27 / 16/11/20

14.0

DC

DOCUMENT CONTROL



Comment: DOCUMENT CONTROL

2306/11/28

Job Completion



U 5611.28

13 add to kit per CHG 002
4 x AN5-32A M14781 ✓
4 x MS21042LS M102171 ✓
8 x AN960 JD516 M100564 ✓
B 06/11/27

NEEDS
TO ADD TO
computer system

A 50212

13b Inspect kit / 16/11/21 (1)

13c Repackage per PPP using new B/N (CHG 002)
New labels + paper work req'd

New c
16/11/21

Return to stock ✓
4x AN5-32A M12307
4x MS21042LS MS2889
8x AN960 JD516 M11325

Dart Aerospace Ltd

W/O:		WORK ORDER CHANGES					
DATE	STEP	PROCEDURE CHANGE	By	Date	Qty	Approval Chief Eng / Prod Mgr	Approval QC Inspector

Part No: _____ PAR #: _____ Fault Category: _____ NCR: Yes No DQA: _____ Date: _____

QA: N/C Closed: _____ Date: _____

NCR:		WORK ORDER NON-CONFORMANCE (NCR)						
DATE	STEP	Description of NC Section A	Corrective Action Section B			Verification Section C	Approval Chief Eng	Approval QC Inspector
			Initial Chief Eng	Action Description Chief Eng	Sign & Date			

NOTE: Date & initial all entries

DART

DESIGN PH	DRAWN BY PH	DART AEROSPACE LTD HAWKESBURY, ONTARIO, CANADA	
CHECKED HDS	APPROVED HDS	DRAWING NO. D206-667-141	REV. B SHEET 1 OF 3
DATE 05.07.26		TITLE CROSSTUBE ASS'Y (206B HIGH FWD)	SCALE NTS
A	00.11.17	NEW ISSUE	
B	05.07.26	ADD HOLES AND NUT PLATES FOR COMPATABILITY WITH BHT/AA SKIDTUBES	

RELEASED
05.07.26 HUNDER REVIEW
06.08.10 AH
re.drw detail F

Qty	Part Number	Description
X	D206-667-141	CROSSTUBE ASSEMBLY (206B HIGH FWD)
1	D6001-105	CROSSTUBE
2	D2856-400-694	ABRASION STRIP
2	D2873-043	NUT PLATE
2	D2873-045	NUT PLATE
2	D2891-1	SUPPORT
14	MS20601AD4W8	RIVET (OR NAS9302B-4-8)
4	MS21920-20	CLAMP







REFERENCE ONLY

GENERAL NOTES:

- 1) TOLERANCES ARE PER DART QSI 018 UNLESS OTHERWISE NOTED.
- 2) MATERIAL: MANUFACTURED FROM D6001-105
FINISHED LENGTH = 93.18 ± 0.020
- 3) FINISH: CHEMICAL CONVERSION COAT PER DART QSI 005 4.1
PRIME INSIDE AND OUTSIDE PER DART QSI 005 4.2
PAINT OUTSIDE PER DART QSI 005 4.2
- 4) PART IS SYMMETRIC ABOUT CENTERLINE.
- 5) RUN-OFF PART. BLEND OUT EDGE LONGITUDINALLY, TRANSITION SHOULD BE SMOOTH.
- 6) BEND PROGRESSIVELY WITH A MINIMUM OF 12 PASSES. MAXIMUM TUBE FLATTENING DUE TO BENDING IS 6% BASED ON O.D.
- 7) LIQUID PENETRANT INSPECT OUTSIDE SURFACE OF CROSSTUBE PER QSI 038.
- 8) SCRIBE DART PART NUMBER AND BATCH NUMBER IN THIS AREA WITH VIBRATING STYLUS.
- 9) INSTALL D2856-400-694 ABRASION STRIP WITH A 0.13 (REF) GAP ON BOTTOM SIDE OF CROSSTUBE, CENTERED OPPOSITE D2891-1 SUPPORT, PER QSI 035.
- 10) EXTREME CARE MUST BE TAKEN TO PROTECT THE OUTSIDE SURFACE OF THE TUBE. THE OUTSIDE SURFACE MUST BE SMOOTH AND FREE FROM SURFACE DEFECTS SUCH AS SCRATCHES, NICKS, OR DENTS. DEFECTS UP TO 0.005" MAY BE BLENDED OUT LONGITUDINALLY. CIRCUMFERENTIAL GRIND MARKS ARE UNACCEPTABLE.
- 11) IT IS OPTIONAL TO SEAL EDGES OF SUPPORTS AND ABRASION STRIP USING SIKAFLEX-241/291 SEALANT.
- 12) TORQUE CLAMPS 80 TO 100 IN-LB.


Copyright © 2000 by DART AEROSPACE LTD

THIS DOCUMENT IS PRIVATE AND CONFIDENTIAL AND IS SUPPLIED ON THE EXPRESS CONDITION THAT IT IS NOT TO BE USED FOR ANY PURPOSE OR COPIED OR COMMUNICATED TO ANY OTHER PERSON WITHOUT WRITTEN PERMISSION FROM DART AEROSPACE LTD.

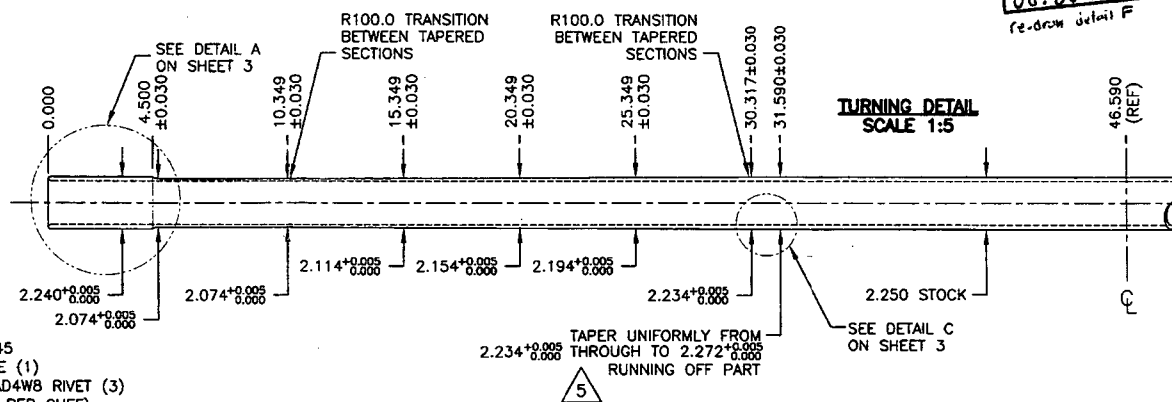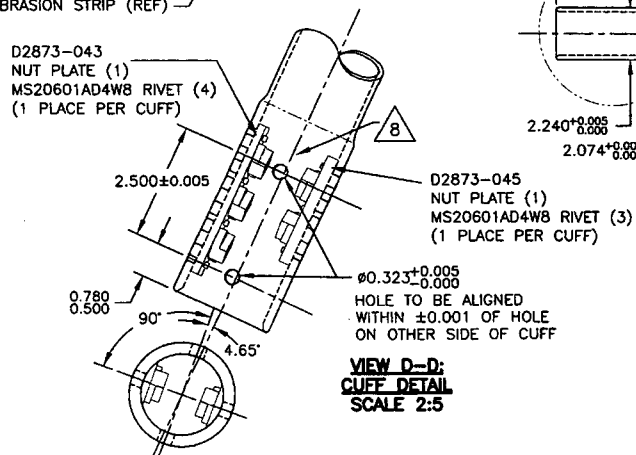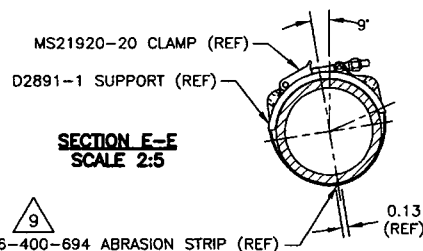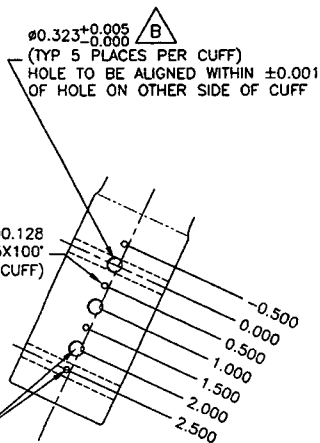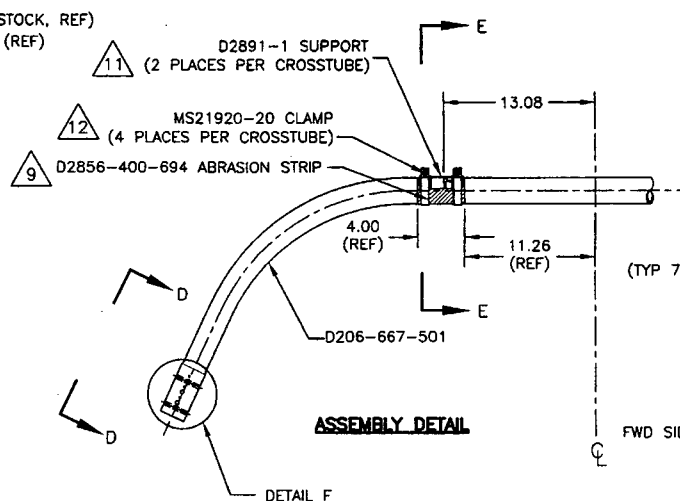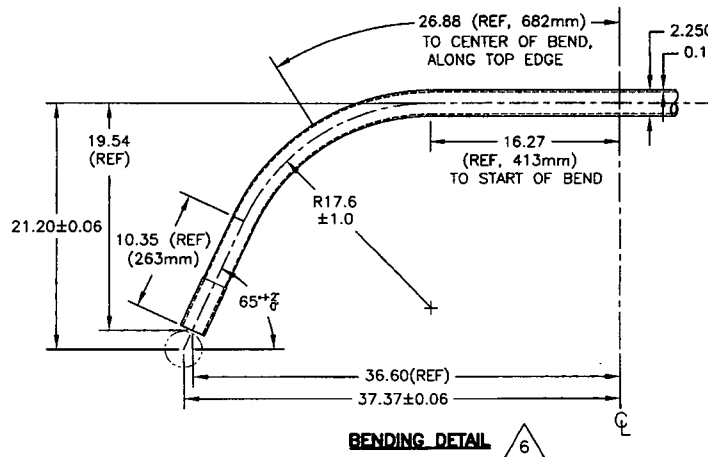


UNDER REVIEW
06.08.10 PH
re-work detail F

COPYRIGHT © 2000 BY DART AEROSPACE LTD.		DESIGN	DRAWN BY	DART	DART AEROSPACE LTD. MARKHAM, ONTARIO, CANADA
THIS DOCUMENT IS PRIVATE AND CONFIDENTIAL AND IS SUPPLIED ON THE EXPRESS CONDITION THAT IT IS NOT TO BE USED FOR ANY PURPOSE OR COPIED OR COMMUNICATED TO ANY OTHER PERSON WITHOUT WRITTEN PERMISSION FROM DART AEROSPACE LTD.		PH	PH		
DATE		CHECKED	APPROVED	DRAWING NO.	REV. B
05.07.26		PH	PH	D206-667-141	SHEET 2 OF 3
TITLE		CROSSTUBE ASS'Y (206B HIGH FWD)			SCALE
					1:10

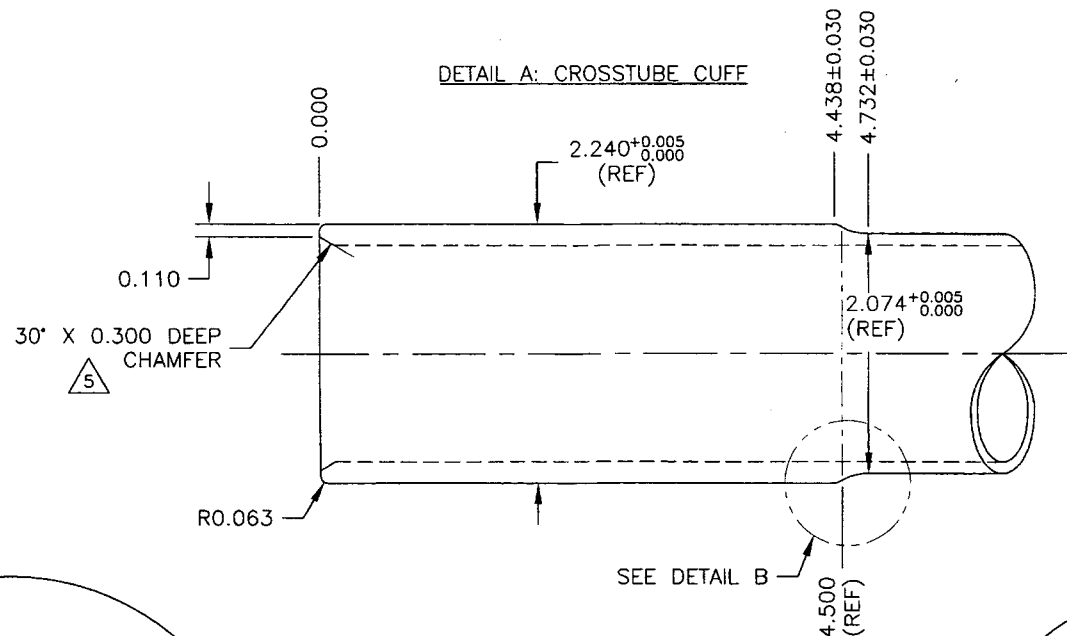


UNDER REVIEW
06.08.10 PH
re-draw detail F

05.07.26

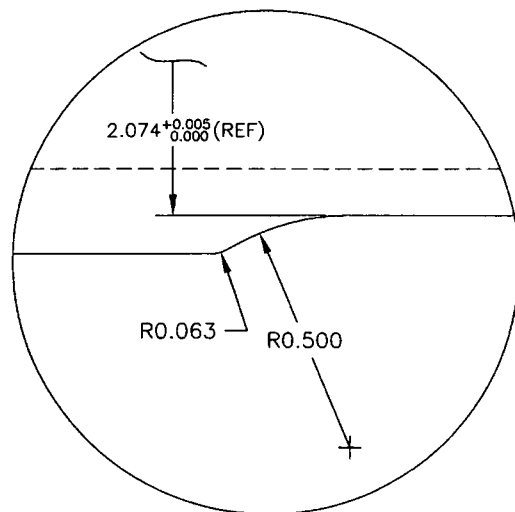

DETAIL C:
TAPER RUN-OFF
NOT TO SCALE

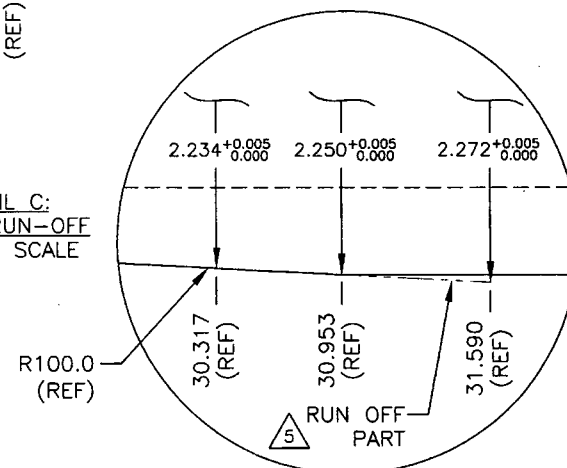

COPYRIGHT © 2000 BY DART AEROSPACE LTD.

THIS DOCUMENT IS PRIVATE AND CONFIDENTIAL AND IS SUPPLIED ON THE EXPRESS CONDITION THAT IT IS NOT TO BE USED FOR ANY PURPOSE OR COPIED OR COMMUNICATED TO ANY OTHER PERSON WITHOUT WRITTEN PERMISSION FROM DART AEROSPACE LTD.

DESIGN
PH

DRAWN BY
PH

DART

DART AEROSPACE LTD.
HAMPSHIRE, ENGLAND, CANADA

CHECKED
DS

APPROVED
DS

DRAWING NO.
D206-667-141

REV. B
SHEET 3 OF 3

DATE
05.07.26

TITLE
CROSSTUBE ASS'Y (206B HIGH FWD)
SCALE
1:1

ANDING GEAR RESOURCE 1

1-Drill pilot holes in tube using drill Jig DT8541 & DT8542 as per Dwg D206-667-141. Drill all (3) top holes.

2-Drill & ream holes as per Dwg D206-667-141 using drill Jig DT8575 & DT8576. Drill all (3) top holes.

3-Flip tube and switch drilling Jigs from right to left, left to right. Locate Jigs off existing holes using "T" pins.

4-Drill pilot holes using drill Jig DT8541 & DT8542 as per Dwg D206-667-141. Drill only the top (2) holes.


5-Drill pilot holes as per Dwg D206-667-141. Drill only the top (2) holes.

6-Drill Fwd rivet holes using drill Jig DT8787FWD as per Dwg D206-667-141.
Note: Fwd side has 3x top holes.

7-Drill Aft rivet holes using drill Jig DT8787AFT as per Dwg D206-667-141.

8-C'sink holes as per Dwg D206-667-141. Allow rivet to sit below surface to compensate for paint.

9-Deburr & Inspect for surface damage. Repair damage within limits as per Dwg D206-667-141

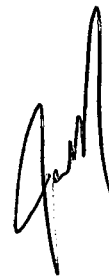A handwritten signature in black ink, appearing to be 'J. Smith' or similar, located in the lower right quadrant of the page.

5.0 PARTS LIST

Item	Qty -011	Qty -013	Qty -015	Qty -101	Qty -201	Qty -103	Qty -203	Qty -105	Qty -205	Part Number	Description
	X									D206-667-011	SPACER BLOCK KIT
		X								D206-667-013	NUT PLATE KIT (-101/-103/-105/-203/-205)
			X							D206-667-015	NUT PLATE KIT (-201)
				X						D206-667-101	CROSSTUBE INSTALLATION, 206A/B HIGH FWD
					X					D206-667-201	CROSSTUBE INSTALLATION, 206A/B HIGH AFT
						X				D206-667-103	CROSSTUBE INSTALLATION, 206L/L-1/L-3/L-4 HIGH FWD
							X			D206-667-203	CROSSTUBE INSTALLATION, 206L/L-1/L-3/L-4 HIGH AFT
								X		D407-667-105	CROSSTUBE INSTALLATION, 407 HIGH FWD
									X	D407-667-205	CROSSTUBE INSTALLATION, 407 HIGH AFT
1				1						D206-667-141	CROSSTUBE ASSEMBLY, 206A/B HIGH FWD
2					1					D206-667-241	CROSSTUBE ASSEMBLY, 206A/B HIGH AFT
3						1				D206-667-143	CROSSTUBE ASSEMBLY, 206L/L-1/L-3/L-4 HIGH FWD
4							1			D206-667-243	CROSSTUBE ASSEMBLY, 206L/L-1/L-3/L-4 HIGH AFT
5								1		D407-667-145	CROSSTUBE ASSEMBLY, 407 HIGH FWD
6									1	D407-667-245	CROSSTUBE ASSEMBLY, 407 HIGH AFT
10				*2	*2	*2		*2		D2891-1	SUPPORT
11							*2			D2892-1	SUPPORT
12									*1	D2894-1	SUPPORT
13				*2	*2	*2		*2		D2856-400-694	ABRASION STRIP
14							*2		*2	D2856-400-773	ABRASION STRIP
15									*1	D2856-600-851	ABRASION STRIP
16				*4	*4	*4		*4		MS21920-20	CLAMP
17							*4		*4	MS21920-22	CLAMP
18									*2	MS21920-24	CLAMP
19				4	4	4		4		AN5-32A	BOLT
20							4		4	AN5-34A	BOLT
21				4	4	4	4	4	4	MS21042L5	NUT (OR MS21042-5)
22				8	8	8	8	8	8	AN960JD516	WASHER
23									*2	D3190-1	CHAFING SHIELD
30	8									AN4-6A	BOLT
31	8									AN4-7A	BOLT
32	16									AN960JD416	WASHER
33	2									D3193-041	SPACER BLOCK ASSEMBLY
40		2		*2		*2	*2	*2	*2	D2873-043	NUT PLATE
41		2		*2		*2	*2	*2	*2	D2873-045	NUT PLATE
42			2		2					D2872-043	NUT PLATE
43			2		2					D2872-045	NUT PLATE
44		10		10		10				AN5-7A	BOLT
45		10	10		10		10	10	10	AN5-10A	BOLT
46		4	4	4	10	4		4		AN5-30A	BOLT
47		4					4		4	AN5-32A	BOLT
48		18	18	10	12	10	10	10	10	AN960JD516	WASHER
49		4	4		6					MS21042L5	NUT (OR MS21042-5)

*REFERENCE ONLY. PARTS ARE INCLUDED IN D206-667-141/241/143/243, & D407-667-145/245 ASSEMBLIES ABOVE

• COPYRIGHT © 2001 BY DART AEROSPACE LTD •

THIS DOCUMENT IS PRIVATE AND CONFIDENTIAL AND IS SUPPLIED ON THE EXPRESS CONDITION THAT IT IS NOT TO BE USED FOR ANY PURPOSE OR COPIED OR COMMUNICATED TO ANY OTHER PERSON WITHOUT WRITTEN PERMISSION FROM DART AEROSPACE LTD.

Revision: C

Date: 05.07.26

Date: Wednesday, 11/22/2006 3:26:31 PM
 User: Kim Johnston

Process Sheet

Customer	: CC-DAR01 Dart Aerospace Ltd.	Drawing Name	: D206667101
Job Number	: 29261	Part Number	: D206667101
Estimate Number	: 10804	Drawing Number	: CHG 002
P.O. Number	:	Project Number	:
This Issue	: 11/22/2006 S.O. No. :	Drawing Revision	:
Prsht Rev.	: NC	Material	:
First Issue	: 11/2/2006 Type : LANDING GEAR	Due Date	: 11/10/2006 Qty: 1 Um: Each
Previous Run	: 29256		
Written By	:		
Checked & Approved By	:		
Comment	:		

Additional Product

Job Number:



Seq. #:	Machine Or Operation:	Description :
---------	-----------------------	---------------

1.0	LANDING GEAR 1	LANDING GEAR RESOURCE 1
-----	----------------	-------------------------



Comment: LANDING GEAR RESOURCE 1
 BUFF CUFFS, DRILL OEM HOLES PER CHG 002

REFERENCE ONLY

06.11.22

Parkerwork confanis

DSI 9346
Rev. C

2.0	D206667101	Crosstube Installation
-----	------------	------------------------



Comment: Qty.: 1.0000 Each(s)/Unit Total : 1.0000 Each(s)
 Crosstube Installation
 B _____

3.0	QC5	INSPECT WORK TO CURRENT STEP
-----	-----	------------------------------



Comment: INSPECT WORK TO CURRENT STEP

4.0	SPRAY PAINTING	SPRAY PAINTING
-----	----------------	----------------



Comment: SPRAY PAINTING
 MASK AND
 RE-PRIME & REPAINT CUFFS

Job Completion

